


SUITE 725
AS-BUILT - 1 OF 1
METROPOLITAN
2,335 RSF
SCALE: 1/8" = 1'-0"
DATE: AUGUST 4, 2021



KEY PLAN

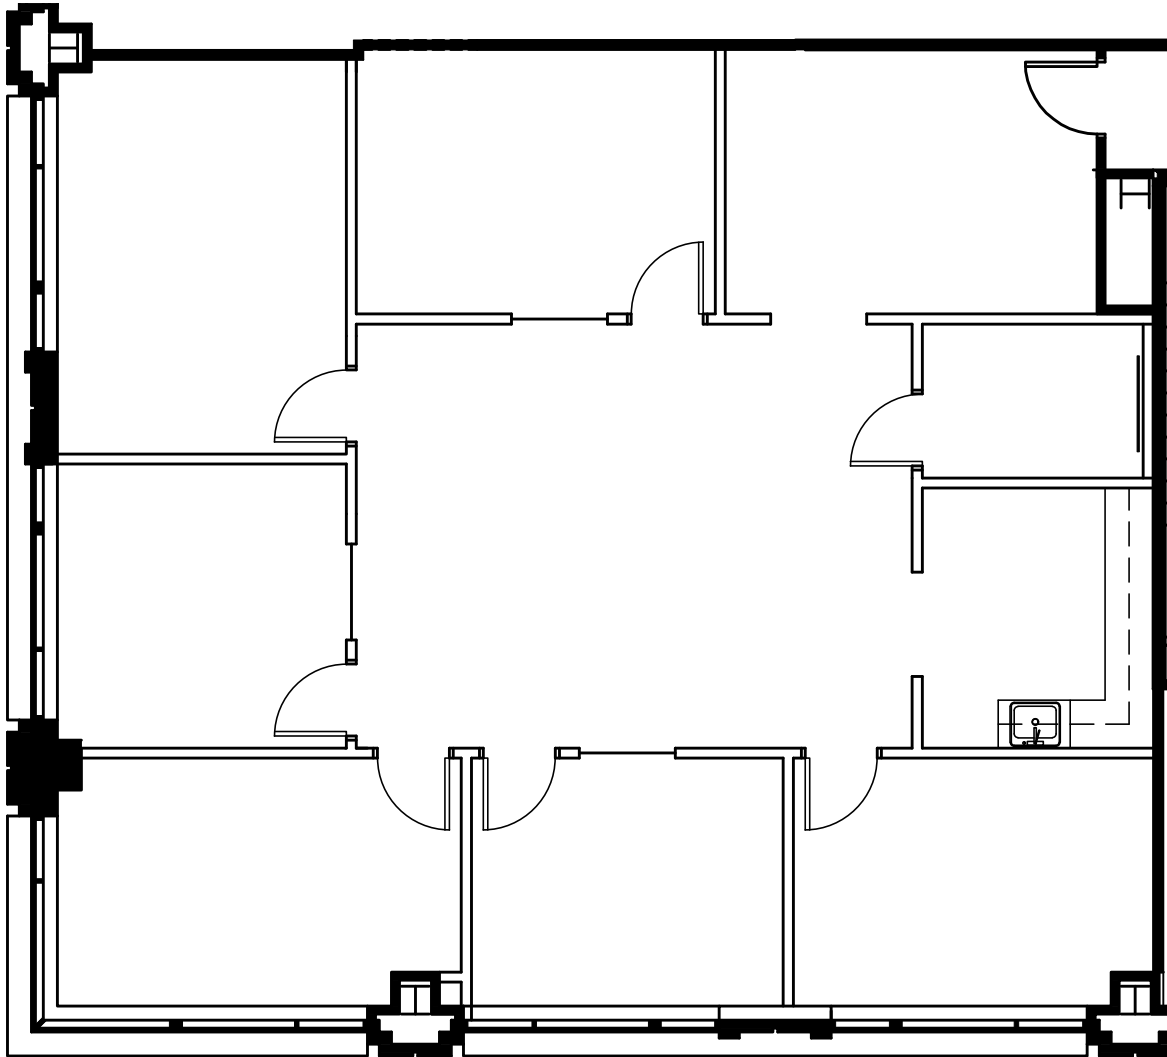

SUMMARY

1	RECEPTION
1	BREAK ROOM
5	OFFICES
1	CONFERENCE
1	OPEN AREA
1	IT ROOM

