


SUITE 775  
AS-BUILT - 1 OF 1  
METROPOLITAN  
1,468 RSF  
SCALE: 1/8" = 1'-0"  
DATE: JULY 8, 2021



KEY PLAN

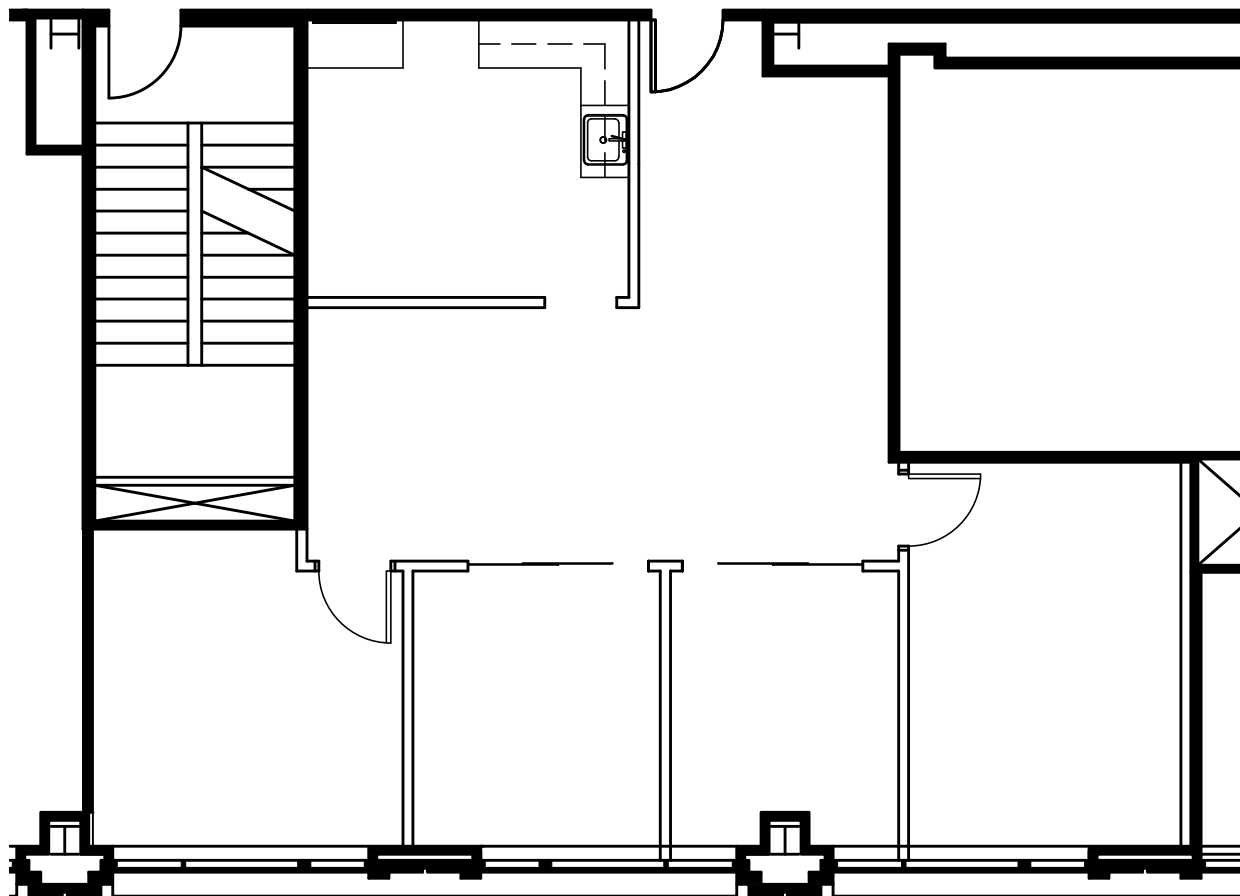

SUMMARY	
1	ENTRY
1	BREAK ROOM
3	OFFICES
1	CONFERENCE
1	OPEN AREA